




8-11-73.  
REVISED.  
24-10-79.  
19-4-93  
16.4.09

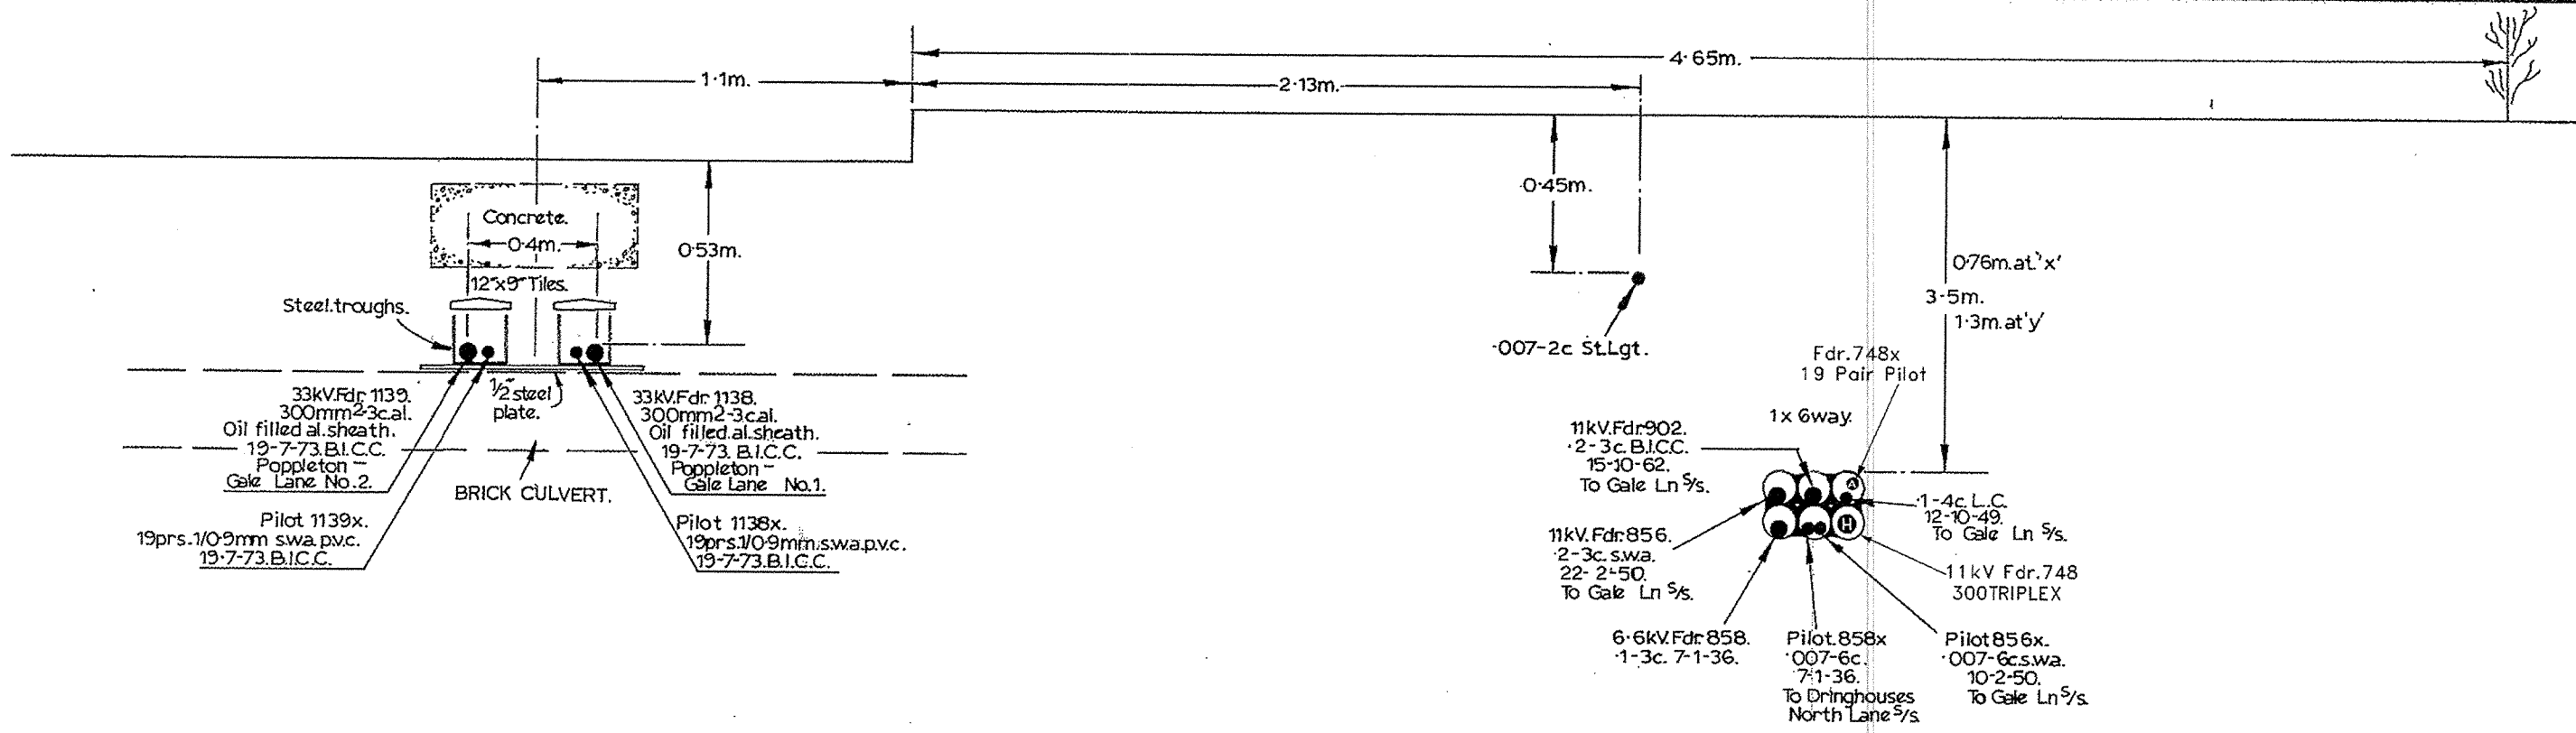


A-B

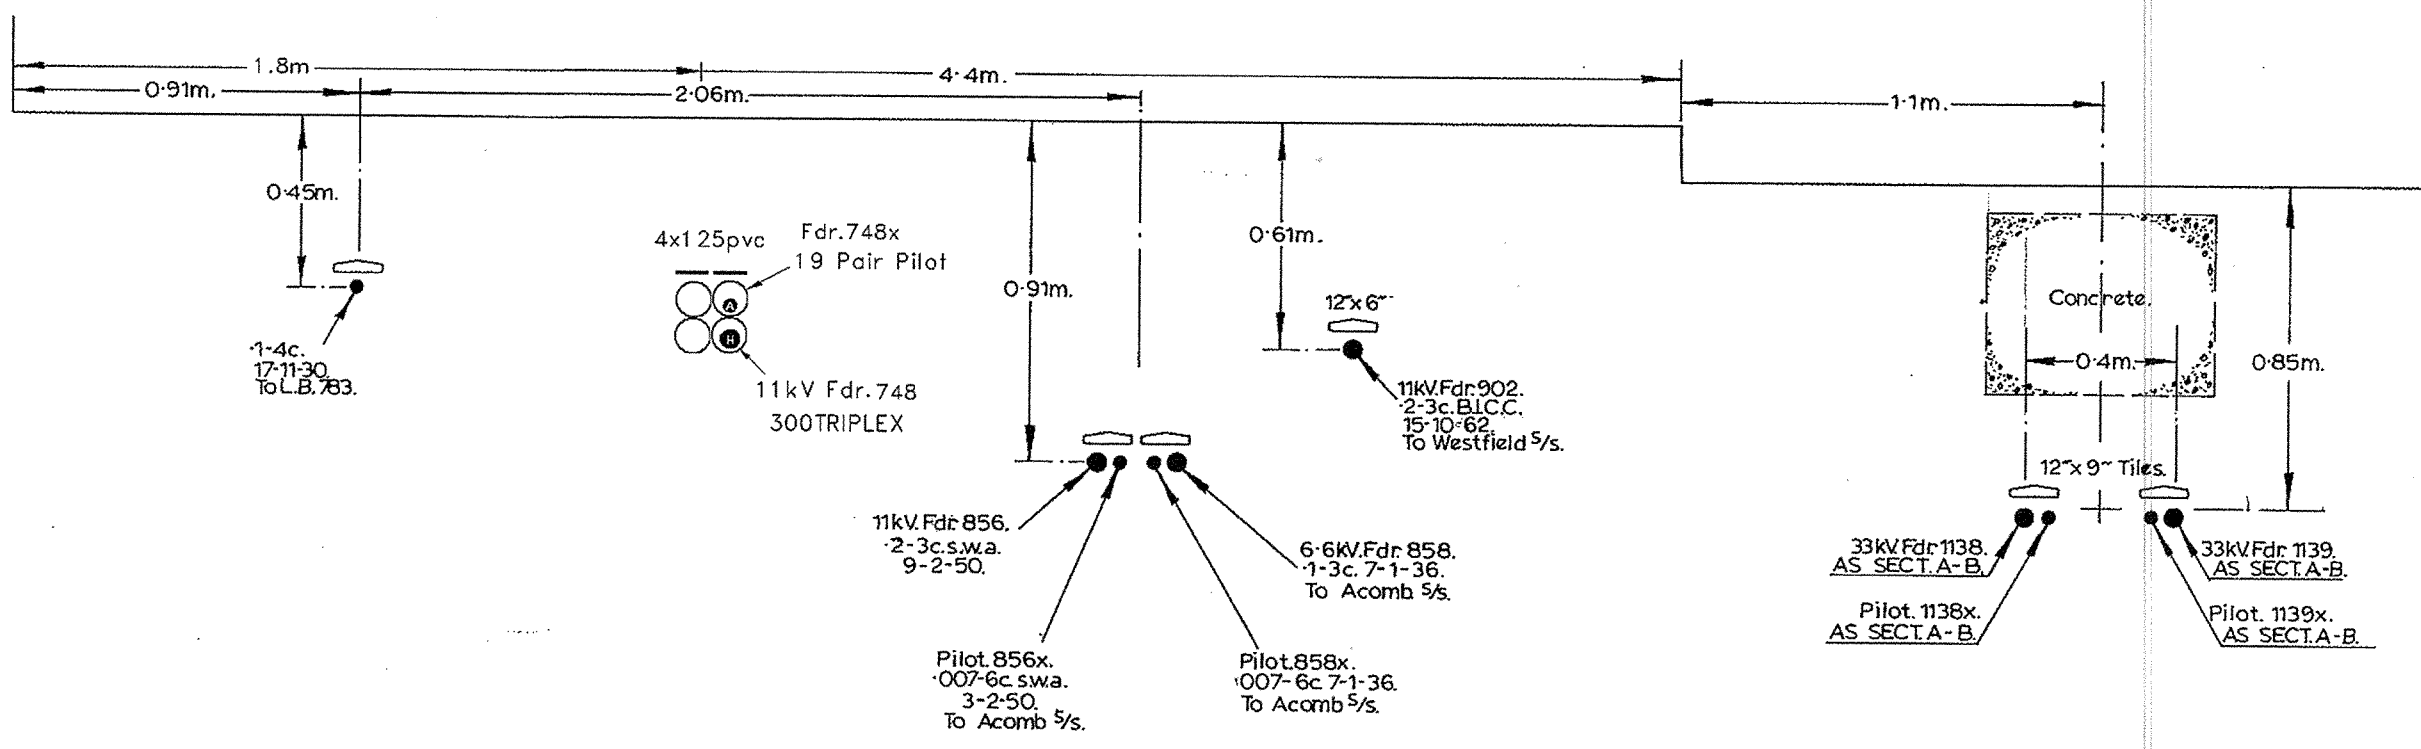


A-C

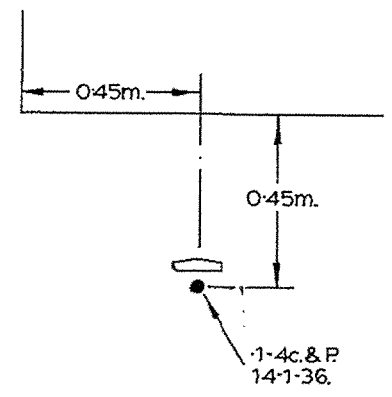

A-D

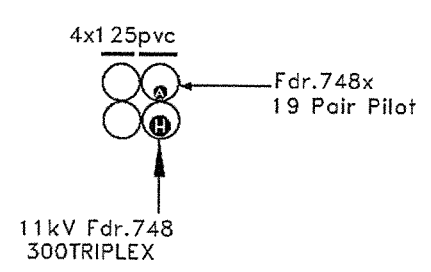

A-E

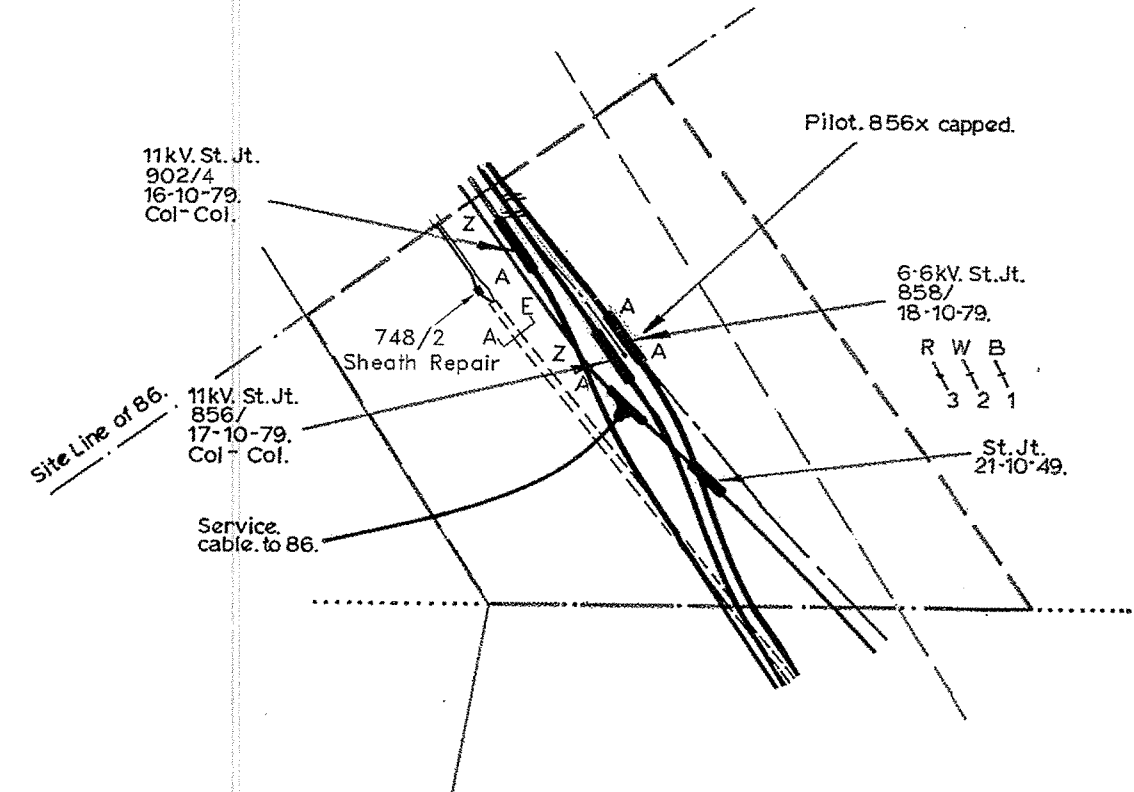

SCALE : 1/100.

RIDINGS/ YORK

SCALE: 1/20.

YORK FACING DETAIL SHEET. No. 1.

SE 572508.

F. SHT. No. 1. SE572508

This sheet is now maintained in GRAPHICAL TOOLS. ( / / / )  
Border Information Checked.  
YES / NO ( / / / )

**NEDL**  
Scale: 1:500  
Map: SE572508.001  
Date: 05 Jun 2009  
Dig Safely  
1. Use Plans  
2. Use Cable Locator  
3. Hand Dig To Confirm

Based upon or Reproduced from the Ordnance Survey Map with the sanction of HM Stationary Office.  
CROWN COPYRIGHT RESERVED  
Unauthorised reproduction infringes Crown Copyright  
NEDL  
Lloyds Court, 78, Grey Street,  
Newcastle Upon Tyne, NE1 6AF

ELECTRIC CABLES AND/OR OVERHEAD LINE INFORMATION SHOWN ON THE RECORD PLANS ARE TO BE USED IN ACCORDANCE WITH THE HEALTH & SAFETY EXECUTIVE'S BOOKLET HS(G)47, "AVOIDING DANGER FROM UNDERGROUND SERVICES", AND GUIDANCE NOTE GS 6, "AVOIDANCE OF DANGER FROM OVERHEAD ELECTRIC LINES". THE RECORD PLANS DO NOT ALWAYS SHOW OUT OF COMMISSION CABLES OR SERVICE CABLES FROM NEDL'S MAINS TO ADJOINING OR CROSS ROAD PROPERTIES. PLANS DO NOT SHOW LOCAL AUTHORITY OWNED PUBLIC LIGHTING OR SIGN CABLES. THE INFORMATION IS PROVIDED AS A SERVICE BY NEDL AND DOES NOT IMPART ANY LEGAL OBLIGATION ON THEIR PART. PERSONS USING IT ARE REMINDED OF THEIR RESPONSIBILITY TO EXECUTE WORKS SAFELY TO AVOID DAMAGING NEDL'S APPARATUS. FURTHER ADVICE OR ASSISTANCE IS AVAILABLE FROM THE RECORDS INFORMATION CENTRE ON 0870 1600910 IN AN EMERGENCY OR OUTSIDE NORMAL WORKING HOURS CONTACT OUR CUSTOMER INFORMATION CENTRE ON 0845 0702703 CABLE DEPTHS SHOWN WERE CORRECT AT THE TIME CABLES WERE LAID HOWEVER ALTERATIONS TO GROUND LEVELS OR CABLE DISPOSITION MAY HAVE TAKEN PLACE

CE ELECTRIC  
09/252403  
Sheet 3 of 6